


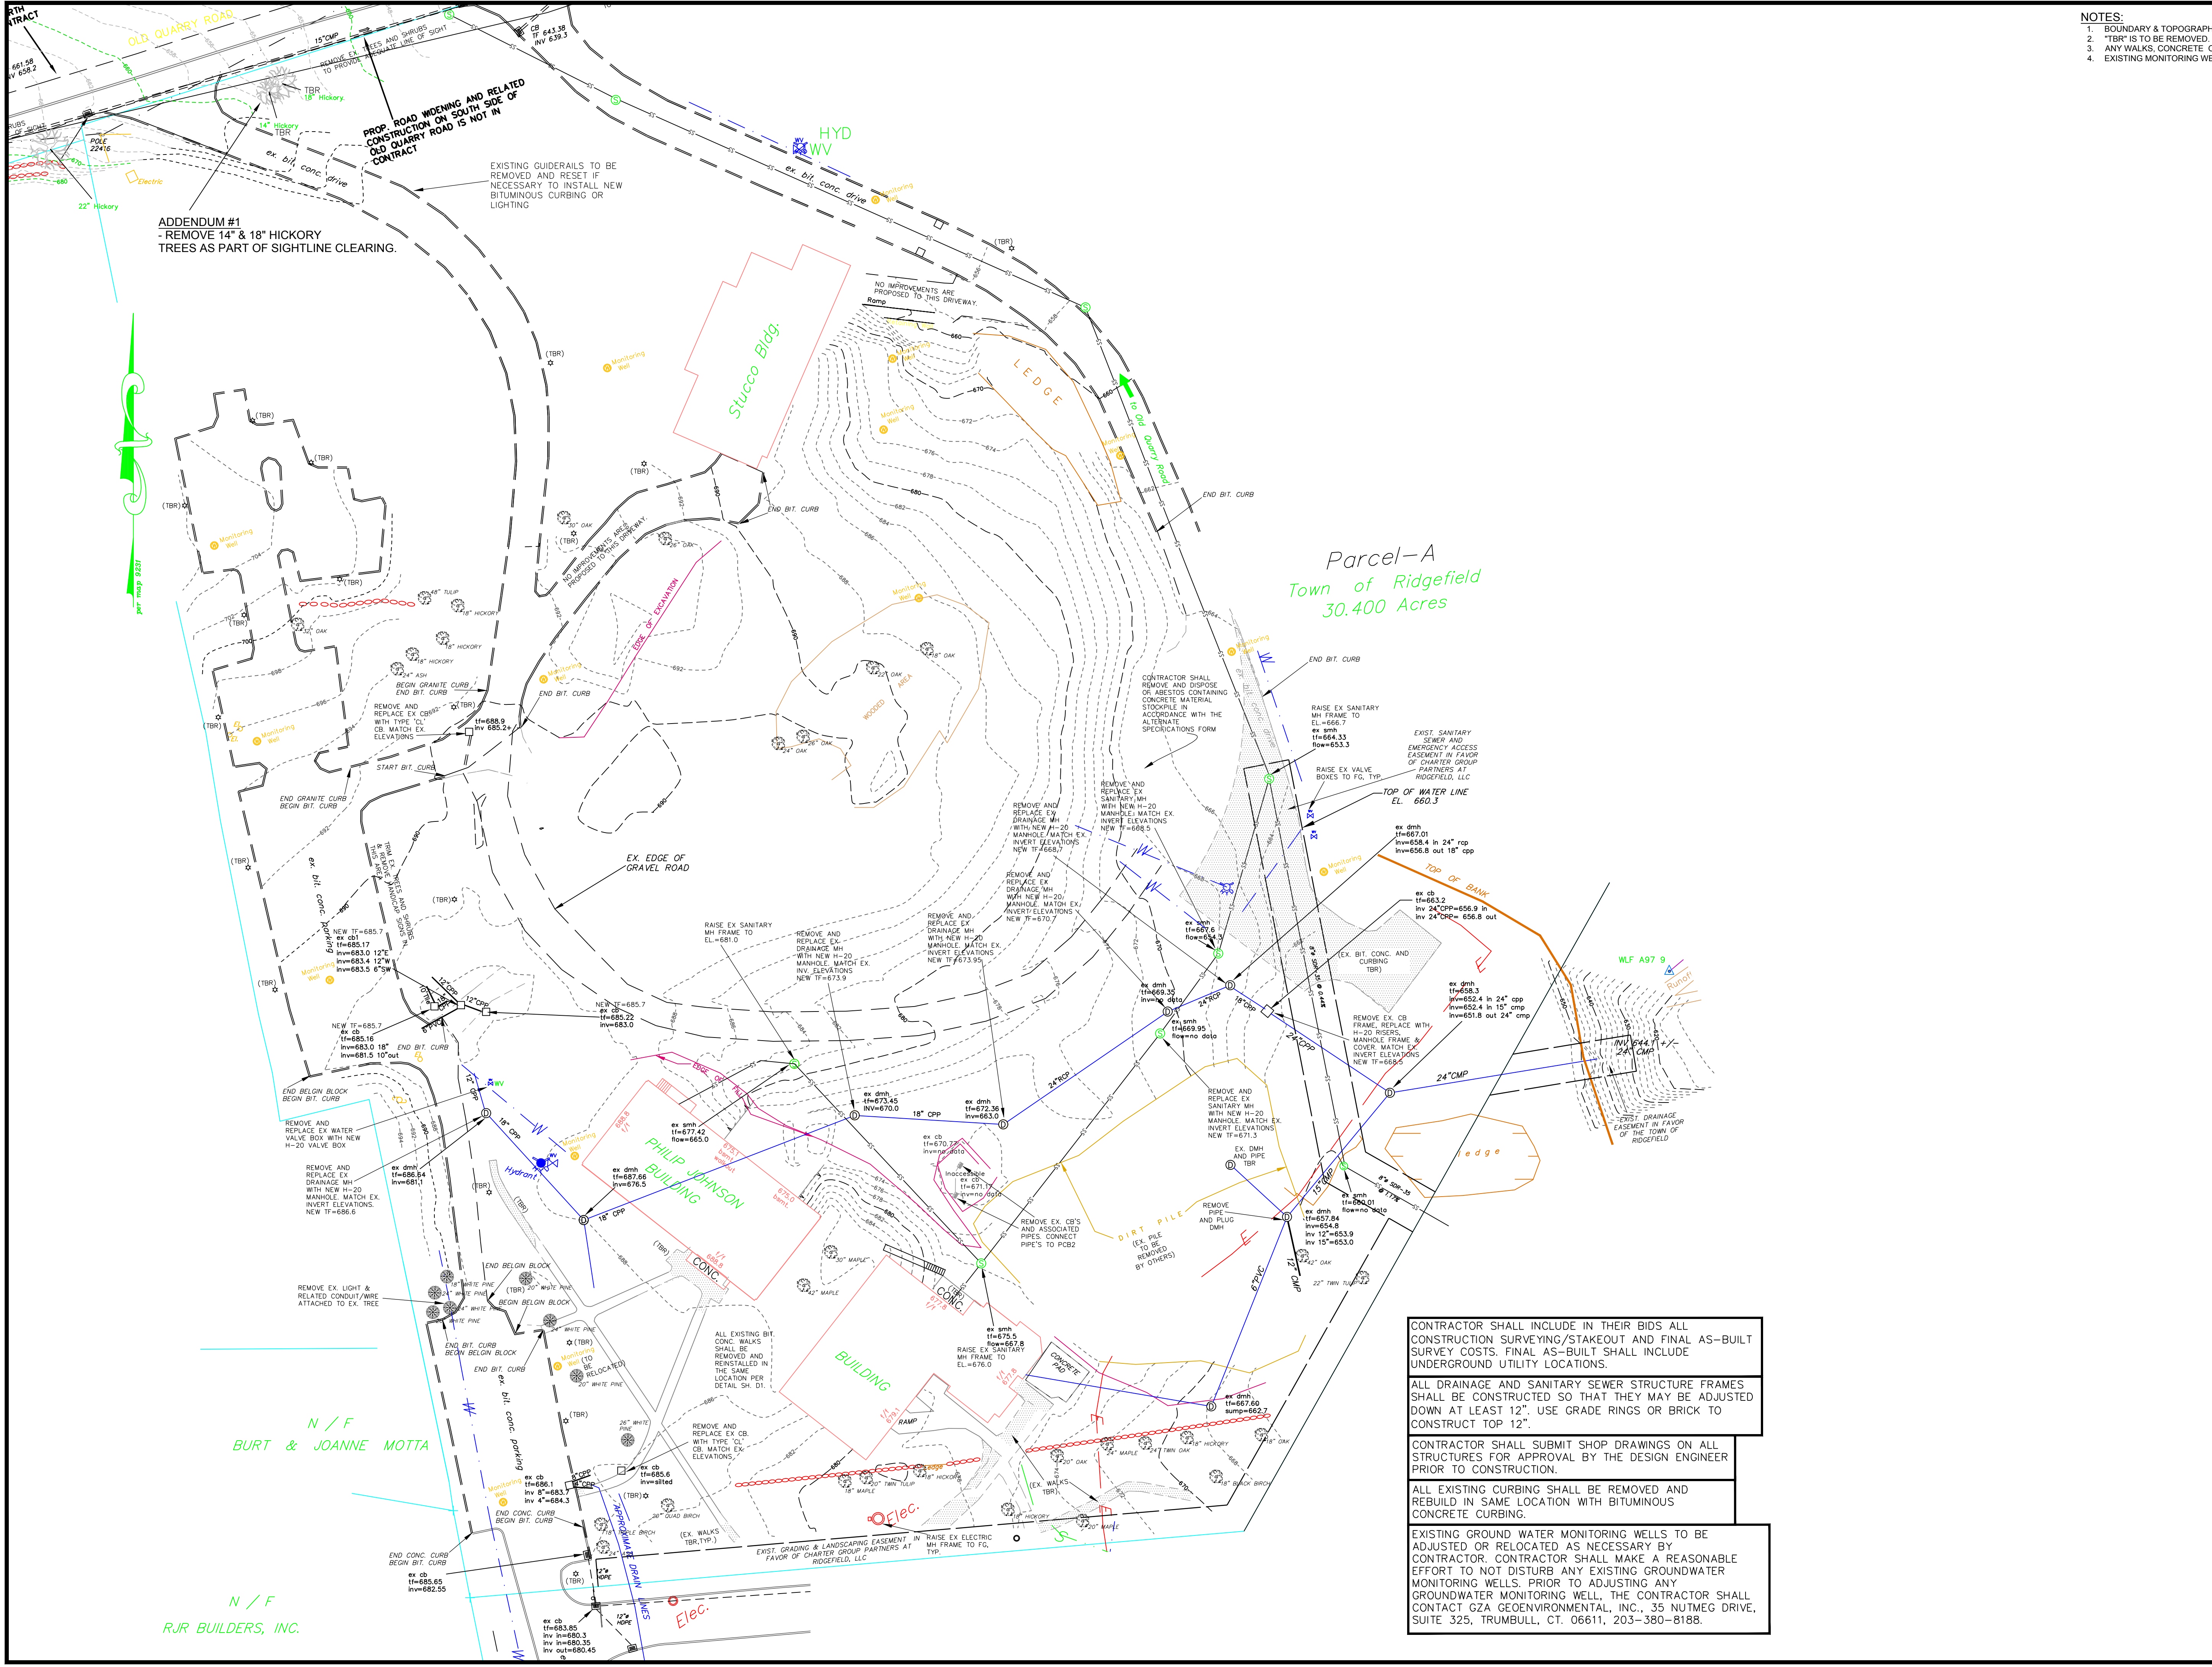

- NOTES:
1. BOUNDARY & TOPOGRAPHIC DATA PREPARED RKW LAND SURVEYING.
 2. "TBR" IS TO BE REMOVED.
 3. ANY WALKS, CONCRETE OR ASPHALT AREAS SHALL BE GRADED IN KIND, TOPSOILED AND SEED.
 4. EXISTING MONITORING WELL LOCATIONS ARE APPROXIMATE AND WERE PROVIDED BY OTHERS.

CONTRACTOR SHALL INCLUDE IN THEIR BIDS ALL CONSTRUCTION SURVEYING/STAKEOUT AND FINAL AS-BUILT SURVEY COSTS. FINAL AS-BUILT SHALL INCLUDE UNDERGROUND UTILITY LOCATIONS.

ALL DRAINAGE AND SANITARY SEWER STRUCTURE FRAMES SHALL BE CONSTRUCTED SO THAT THEY MAY BE ADJUSTED DOWN AT LEAST 12". USE GRADE RINGS OR BRICK TO CONSTRUCT TOP 12".


CONTRACTOR SHALL SUBMIT SHOP DRAWINGS ON ALL STRUCTURES FOR APPROVAL BY THE DESIGN ENGINEER PRIOR TO CONSTRUCTION.

ALL EXISTING CURBING SHALL BE REMOVED AND REBUILT IN SAME LOCATION WITH BITUMINOUS CONCRETE CURBING.


8-22-17	ADDENDUM #1
7-20-17	ISSUED FOR BID
7-13-17	REVISIONS PER CONS. COMM., BID PLANS
DATE	DESCRIPTION

SITE DEMOLITION PLAN
PREPARED FOR
TOWN OF RIDGEFIELD
FORMER SCHLUMBERGER PROPERTY
36 OLD QUARRY ROAD
RIDGEFIELD, CONNECTICUT

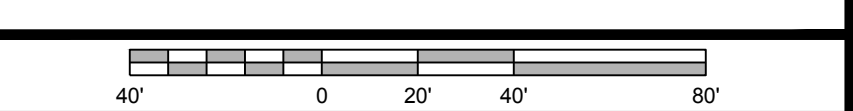

	Date:	06-6-17
	Scale:	1"=40'
	Proj. No:	17-711
	File No:	3734
	Acad No:	17711SP
	Sheet:	C1
	Drawn by:	KT/BS